


As-built

Rev A	Jul 10, 2007	
Rev B	Jul 13, 2007	Straight-through path
Rev C	Jul 16, 2007	Wider dock lift for MMIRS
Rev D	Apr 20, 2009	Added location G; 10x10 door inside
Rev E	Oct 07, 2009	Modified some dimensions to measured values
Rev F	Dec 27, 2010	Moved gowning area to accomodate MMIRS

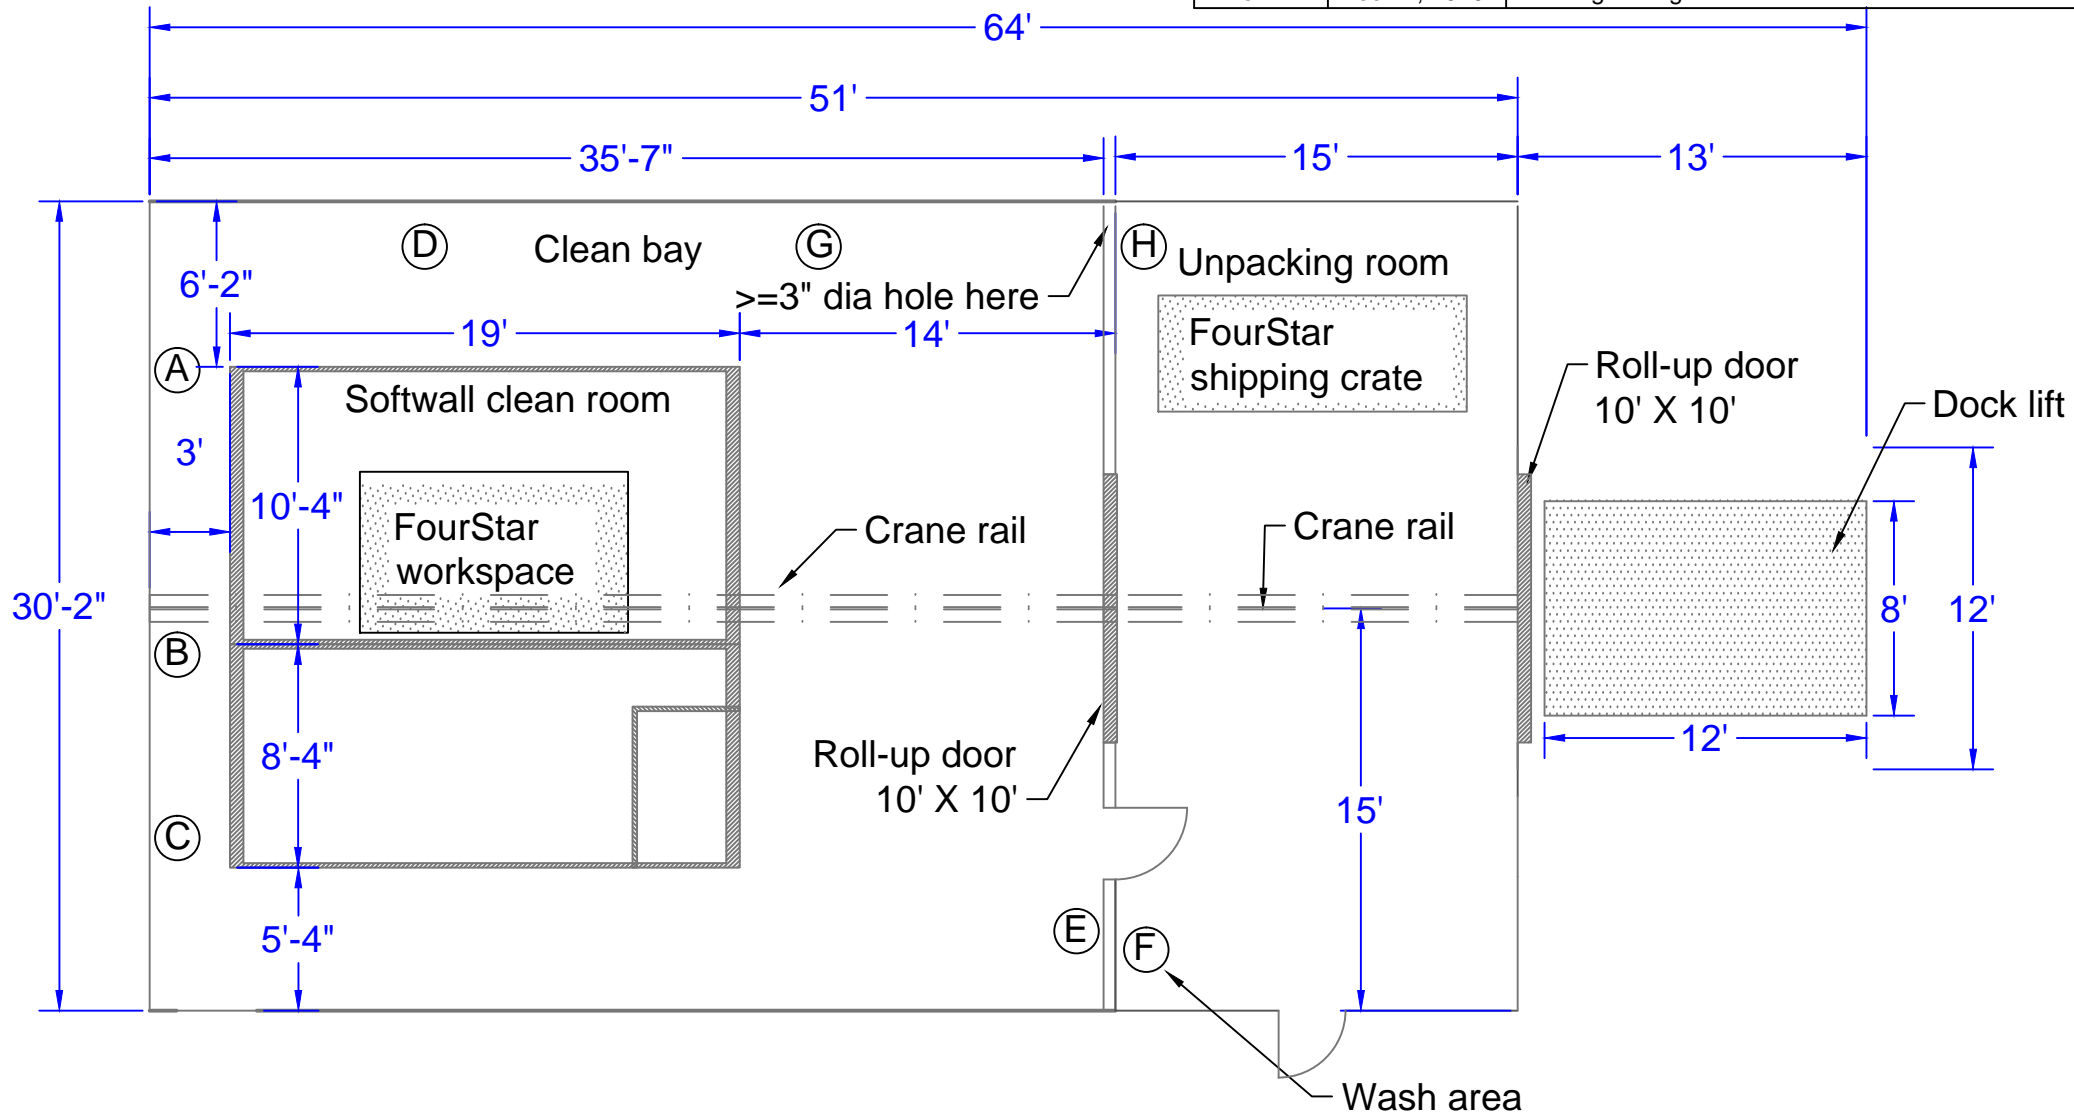

LCO Cleanroom		
plan		
A. Uomoto 626-304-0278 Carnegie Observatories		Rev F